


MADE IN AMERICA
 BY AMP INCORPORATED, ALL RIGHTS RESERVED
 UNPUBLISHED COPYRIGHT
 REPRODUCED NOR TRANSMITTED
 WITHOUT WRITTEN PERMISSION
 OF AMP INCORPORATED.

| REVISIONS | | | |
|-----------|--------------------|-------------|----------|
| LTR | DESCRIPTION | DATE | APPROVED |
| O | NPS 74-0337 | PM 6-4-74 | JM |
| A | REVISED ECN P-7424 | PM 12/20/74 | L.D. |
| B | INACT P9268 | 12-13-82 | JM |
| C | OBS -4 REV G 2589 | BT 10-12-87 | JM |

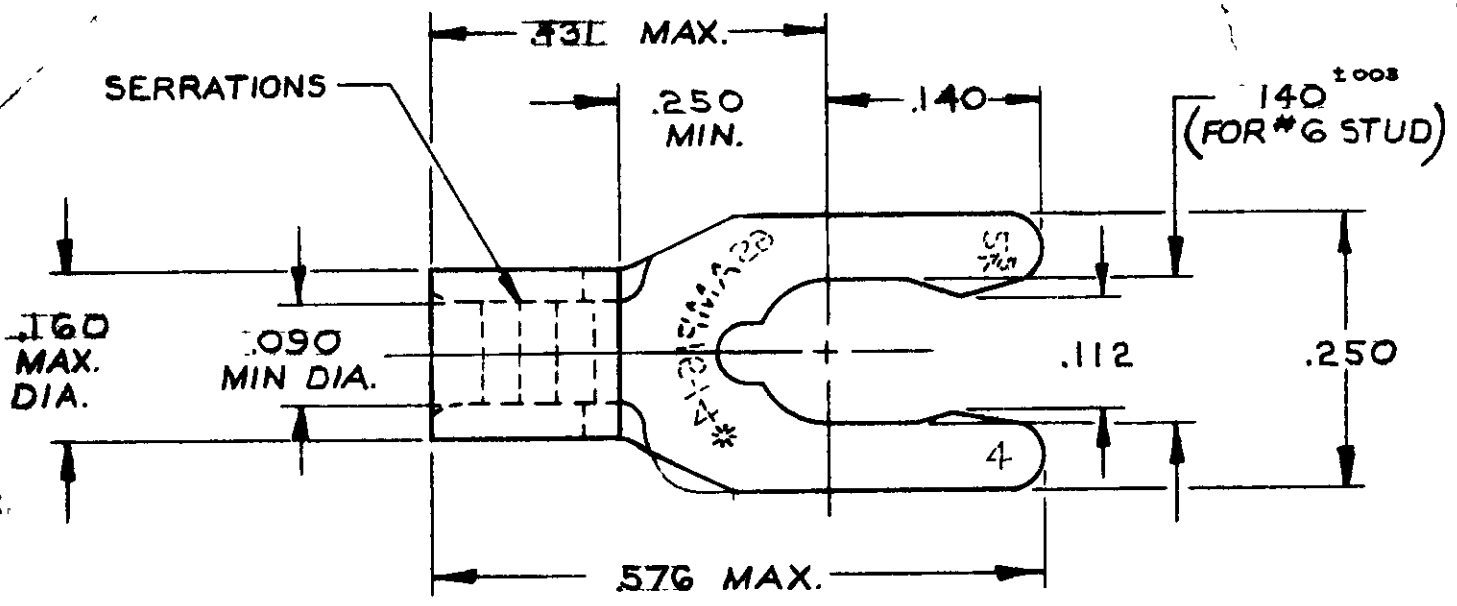

INACTIVE
 P9268
 JM
 12-13-82

~~ENGINEERING CONTROLLED~~

OBSOLETE ~~53010-4~~ 53010-3

PART NO ON TAPE PART NO

UNLESS OTHERWISE SPECIFIED DIMENSIONS ARE IN INCHES
 TOLERANCES ON:
 DECIMALS ±.008
 FRACTIONS ±.005

CONTRACT NO. H
 DR. Phil Monaghan 5-30-74
 CHK. JM Ensminger 6-4-74
 APPD. Les Abel 6-5-74
 REL. Phil Monaghan 8-5-74
 DSGN APPD. JLBrown 6-4-74
 OTHER APPD.



AMP INCORPORATED
 HARRISBURG, PENNSYLVANIA

NAME
 WIRE TERMINAL BUDGET - SPRING SPADE (SHORT)
 WIRE SIZE: 16-14

MATERIAL
 PHOSPHOR BRONZE
 (MIL-C-576)
 TIN PLATED
 (MIL-T-1072)

SIZE A CODE IDENT NO. 00779 NUMBER 53010

SCALE N.T.S. SHEET 1 OF 1

单击下面可查看定价，库存，交付和生命周期等信息

[>>TE Connectivity\(泰科\)](#)