


© - TE Connectivity. All Rights Reserved.

REVISIONS					
P	LTR	DESCRIPTION	DATE	DWN	APVD
F1		REDRAWN - 0K40-0364-03	05MAY03	JRB	KLC
F2		REVISED PER ECO-20-012742	15SEP20	AP	AH

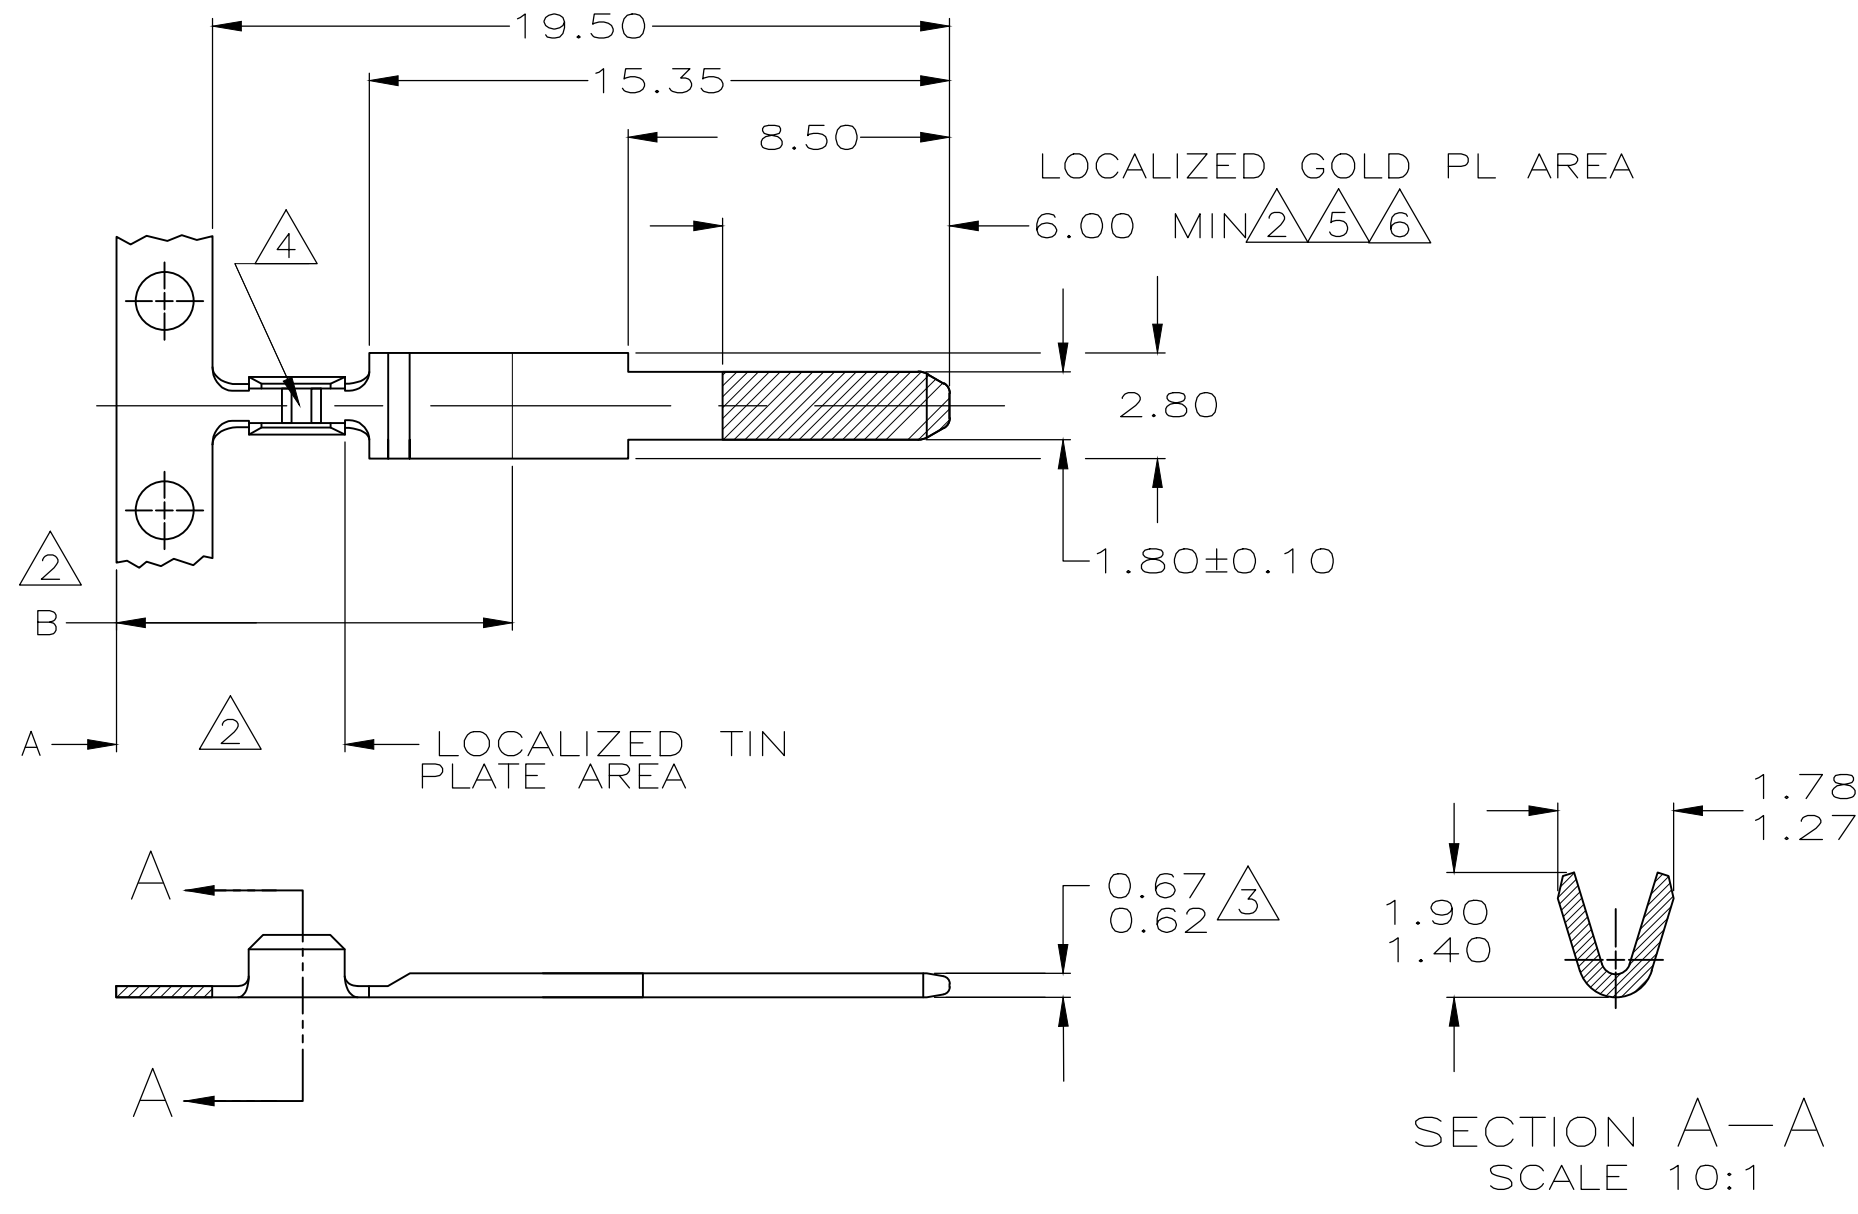

- 1 CONTINUOUS STRIP ON REELS
- 2 FINISH: PLATE 0.00076 MIN THK GOLD IN LOCALIZED GOLD PLATE AREA AND PLATE 0.0025 TO 0.0076 TIN IN LOCALIZED TIN PLATE AREA ALL OVER 0.00200 MIN THK NICKEL.
- 3 INCLUDES PLATING THICKNESS.
- 4 TWO WIRE CRIMP SERRATIONS LOCATED IN THIS AREA.
- 5 DIM 6.0 POINT OF PLATING MEASUREMENT.
- 6 NO POST PLATING TOOL MARKS PERMITTED IN THIS AREA
- 7 FINISH: 0.0038 TO 0.0076 TIN OVER 0.00127 MIN NICKEL.

<del>107-3 FIG. 73</del>	<del>B=10.75</del>	<del>2</del>	<del>SAE CA 260 TEMP 2 BRASS</del>	<del>#30 SOLID</del>	<del>55931-4</del>
<del>107-3 FIG. 72</del>	<del>TOTAL</del>	<del>7</del>	<del>SAE CA 260 TEMP 2 BRASS</del>	<del>#30 SOLID</del>	<del>55931-3</del>
<del>107-3 FIG. 72</del>	<del>A=6.1</del>	<del>2</del>	<del>SAE CA 260 TEMP 2 BRASS</del>	<del>#30 SOLID</del>	<del>55931-1</del>
REELING DIRECTION	Sn PLATING LOCATION	FINISH	MATERIAL	WIRE SIZE	PART NO.

OBSOLETE

THIS DRAWING IS A CONTROLLED DOCUMENT.

DIMENSIONS: mm [INCHES]	TOLERANCES UNLESS OTHERWISE SPECIFIED:	DWN JR RUTH 4/21/93	TE Connectivity ECT/ACT 1.8 X 0.64 SENSOR TAB
	0 PLC ± - 1 PLC ± 0.3 2 PLC ± 0.13 3 PLC ± - 4 PLC ± - ANGLES ± -	CHK P.A. COON 4/21/93	
		APVD - 4/21/93 P.A. COON	
		PRODUCT SPEC - 4/21/93 C.R. RHOADS	
MATERIAL SEE TABLE	FINISH SEE TABLE	APPLICATION SPEC -	NAME SIZE CAGE CODE DRAWING NO RESTRICTED TO
CUSTOMER DRAWING		WEIGHT 0.000000	A300779 C-55931 SCALE 5:1 SHEET 1 OF 1 REV F2

单击下面可查看定价，库存，交付和生命周期等信息

[>>TE Connectivity\(泰科\)](#)