


MARKED UP  
 PRINT  
 K. WRIGHT  
 5/8/03

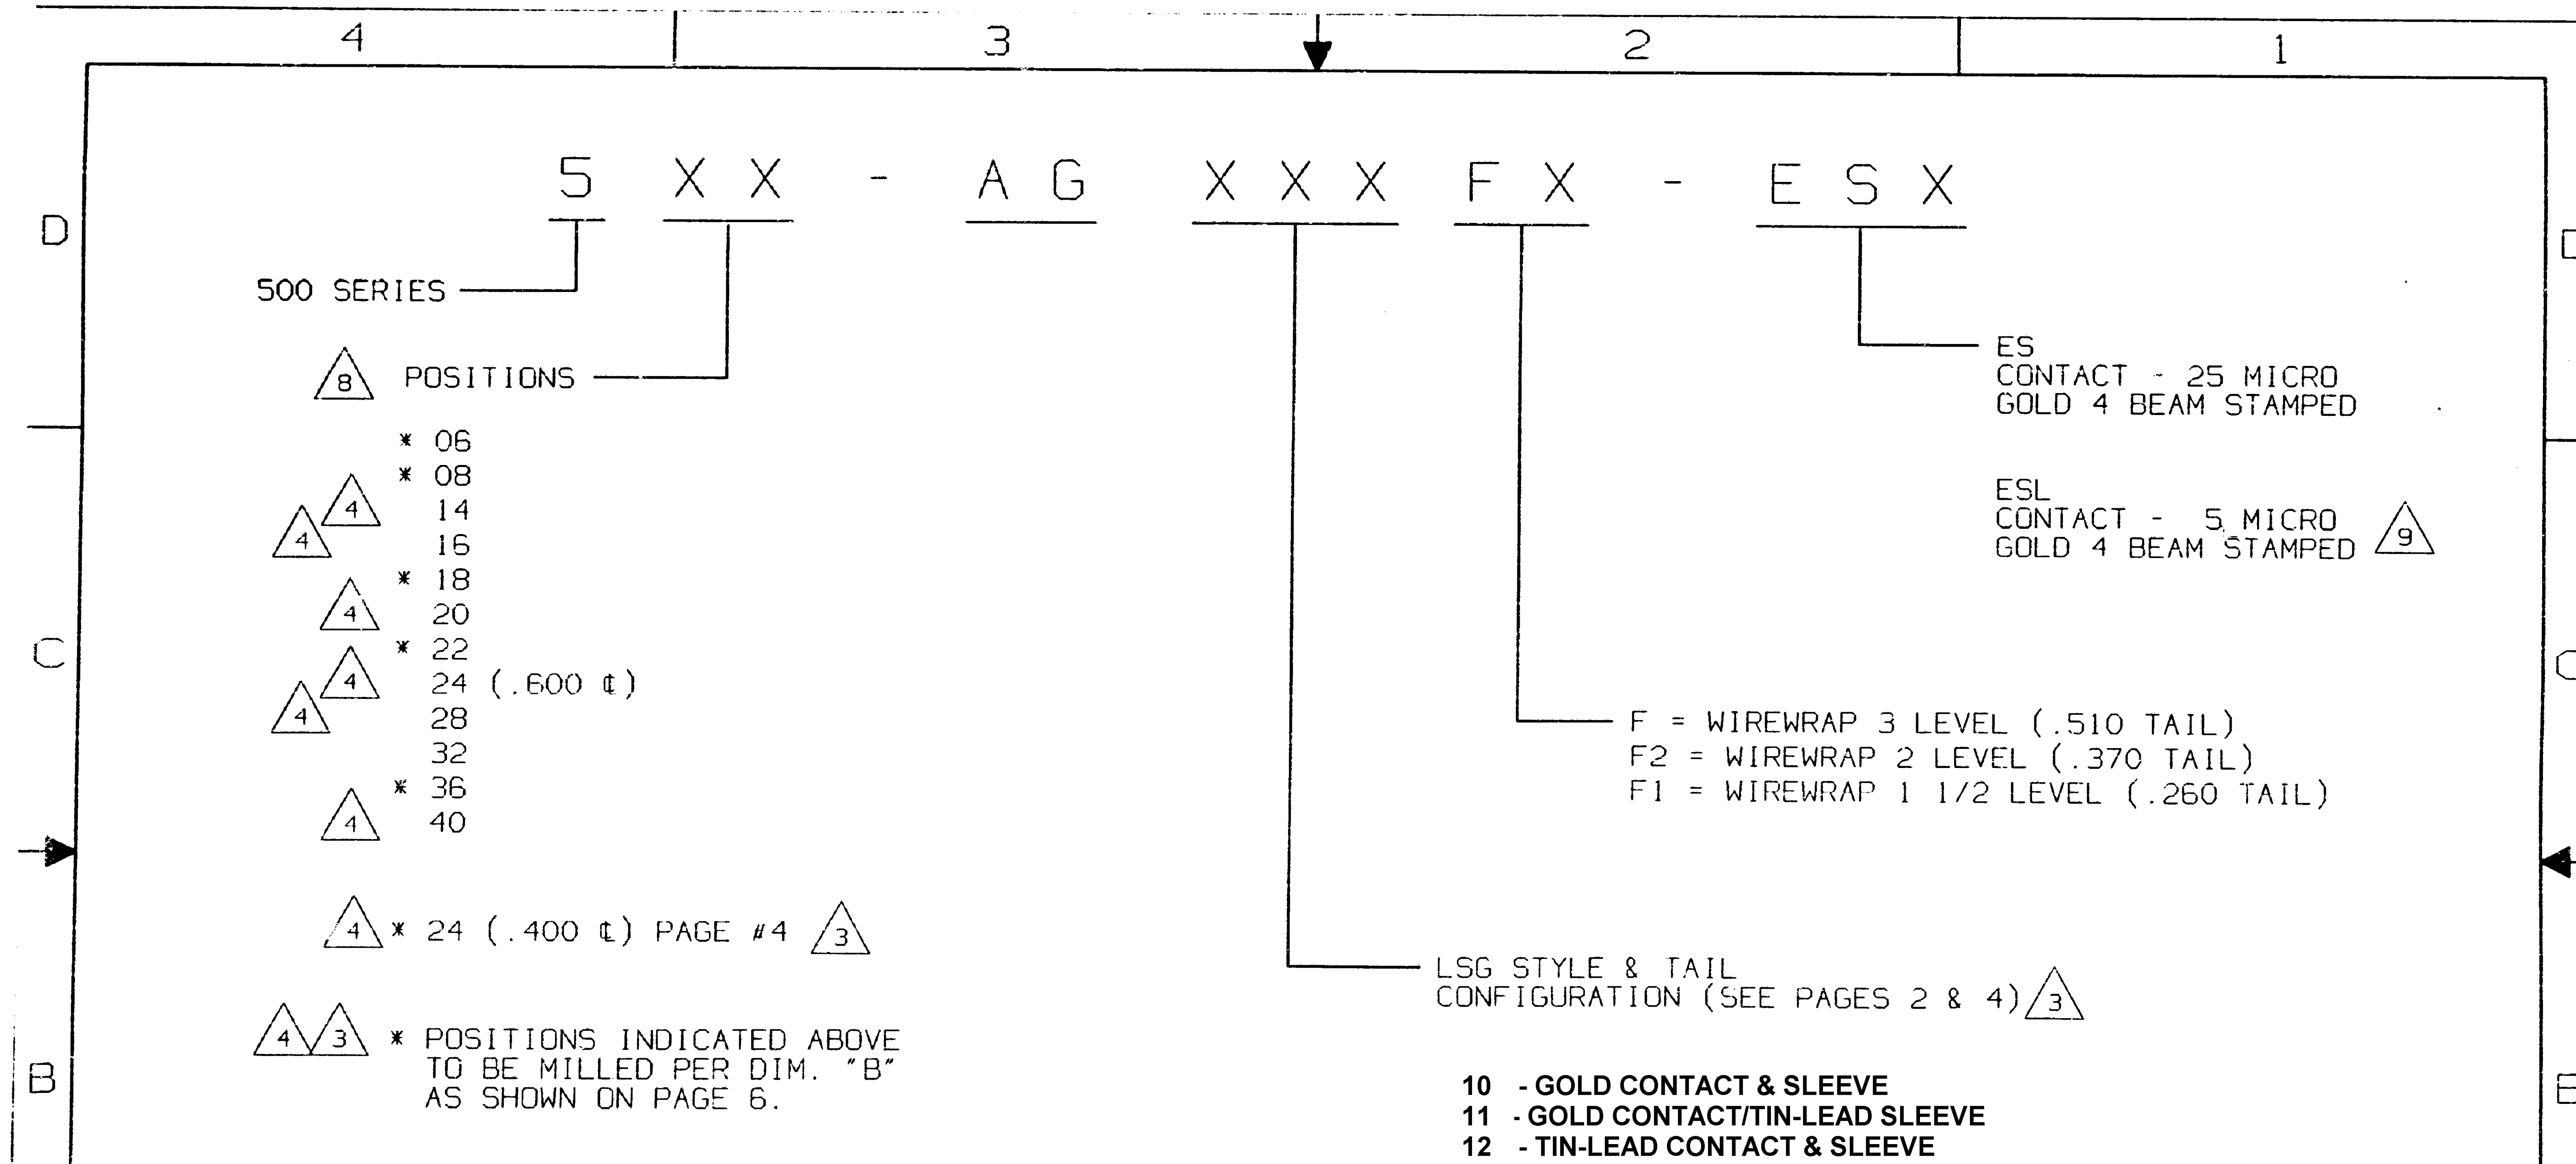


THIS IS A C.A.D. GENERATED DRAWING.  
 DO NOT MAKE MANUAL REVISIONS TO MASTER.

REV	REVISIONS
1	REVISED & REDRAWN CO#C296-37 9-8-10-87 PP'D: AJC 8-27-87
2	REVISED CO#C471-87 3-11-13-87 PP'D: AJC 11-23-87
3	REVISED CO#73-90 5-2-22-90 PP'D: RES 2-25-90
4	REVISED CO#217-90 9-9-13-91 PP'D: ojc 4-2-90
5	REVISED CO#778-91 9-13-91 PP'D: RES 9-17-91
6	REVISED CO#1420-92 1-12-28-92 PP'D: CP
7	REVISED & REDRAWN CO#256-94 KIRCORIAN 9-5-95 PP'D: D.O. 9-25-95
8	REVISED CO# 744-95 S. 10-20-95 PP'D: DO'NEILL 10/24/95
9	REVISED CO# 398-96 D. 7-16-96 PP'D: O'Neill 7/16/96

UNLESS OTHERWISE SPECIFIED DIMENSIONS ARE IN INCHES DO NOT SCALE PRINT			ORIGINAL DATE OF DRAWING: 8-10-87
FILE NAME:	DIRECTORY:	PROJECT:	DRANN: D.SANTOS
500AFS:	PNODEAS:		DATE: 8-10-87
AUGAT CONFIDENTIAL			CHECKED: REV.6 DATE: 12-23-92
This document contains information which is the exclusive property of Augat Inc. Distribution, reproduction or use by others is not permitted without the expressed written			APPROVED: A.CORRIDORI DATE: 8-27-87
CODE IDENT. NO.	DWG. SIZE	91506 B	

<b>AUGAT</b> 452 JOHN DIETSCH BLVD. ATTLEBORO FALLS, MASS. 02763 INC.	
TITLE: ASSEMBLY SOCKET (.260, .370, .510 WW TAIL)	
DWG. NO. 500-AGXXXXF-ES, ESL	REV. 9
PRODUCT CODE: 156	

MARKED UP  
 PRINT  
 K. WRIGHT  
 5/8/03

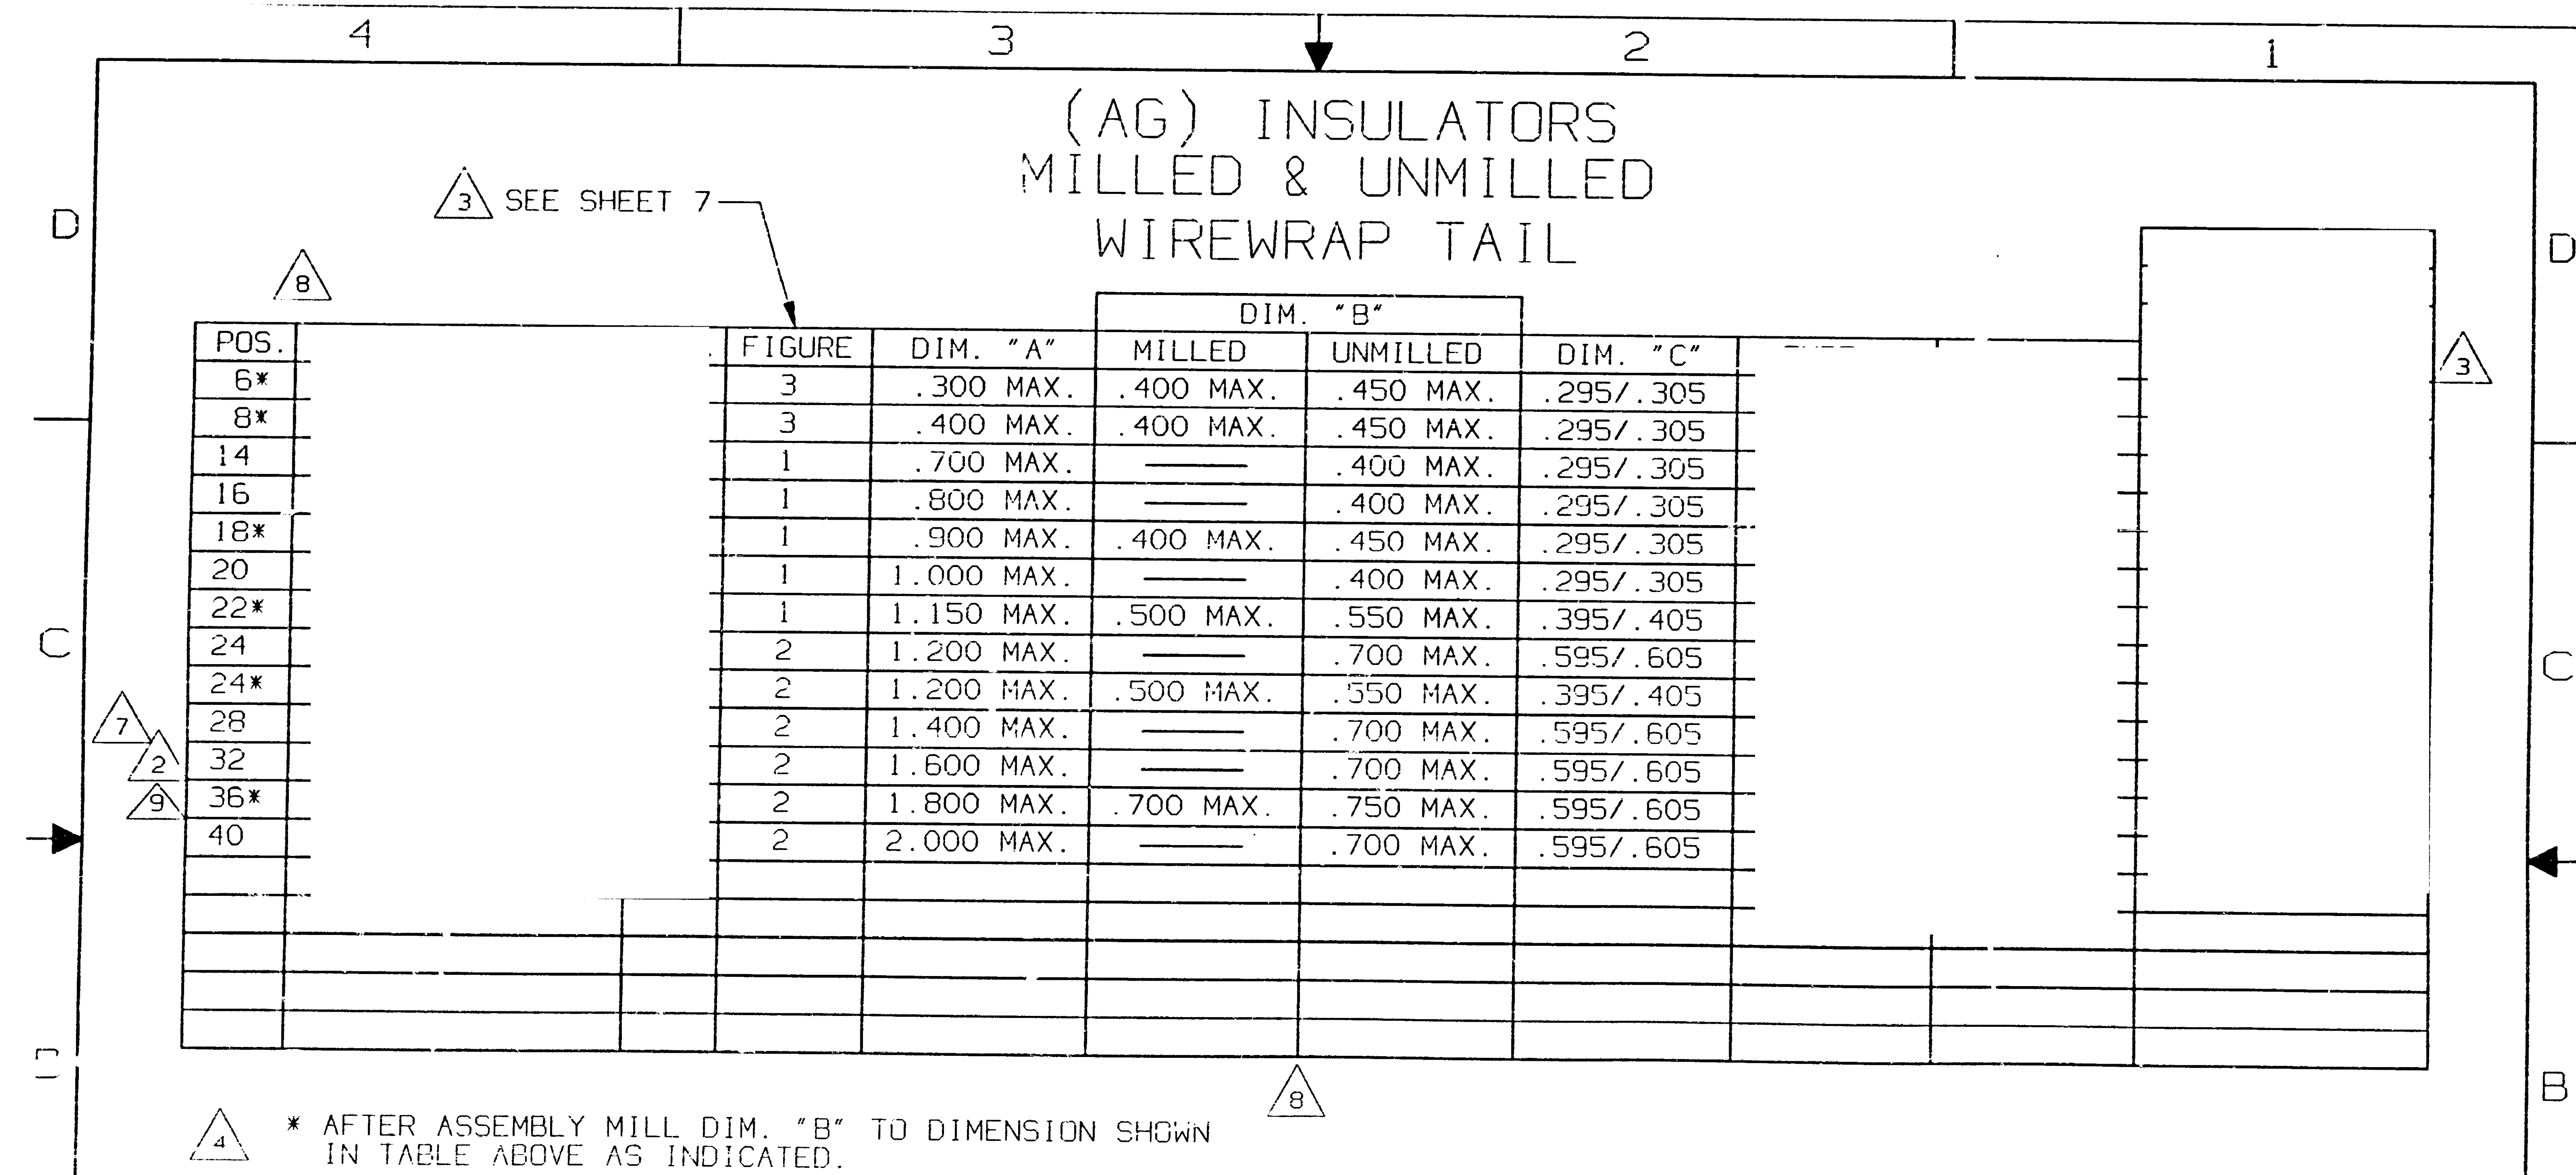

△ 4 \* AFTER ASSEMBLY MILL DIM. "B" TO DIMENSION SHOWN IN TABLE ABOVE AS INDICATED.

THIS IS A C.A.D. GENERATED DRAWING.  
 DO NOT MAKE MANUAL REVISIONS TO MASTER.

REV	SEE SHEET 1
REVISIONS	

UNLESS OTHERWISE SPECIFIED  
 DIMENSIONS ARE IN INCHES  
 DO NOT SCALE PRINT

FILE NAME: 500AGF56 DIRECTORY: PNC00EAS PROJECT:

AUGAT CONFIDENTIAL

This document contains information which is the exclusive property of Augat Inc. Distribution, reproduction or use by others is not permitted without the expressed written consent of Augat Inc.

ORIGINAL DATE OF DRAWING: 8-10-87

DRAWN: D. SANTOS DATE: 8-10-87

CHECKED: REV. 6 RAY-D DATE: 12-29-92

APPROVED: A. CORRADOR DATE: 8-27-87

CODE IDENT. NO. 91506 DWG. SIZE B


**AUGAT** INC. 452 JOHN DIETSCH BLVD. ATTLEBORO FALLS, MASS. 02763

TITLE: ASSEMBLY SOCKET (.260, .370, .510 WW TAIL)

DWG. NO. 500-AGXXXFX-ES, ESL

REV. 9

MARKED UP  
 PRINT  
 K. WRIGHT  
 5/8/03

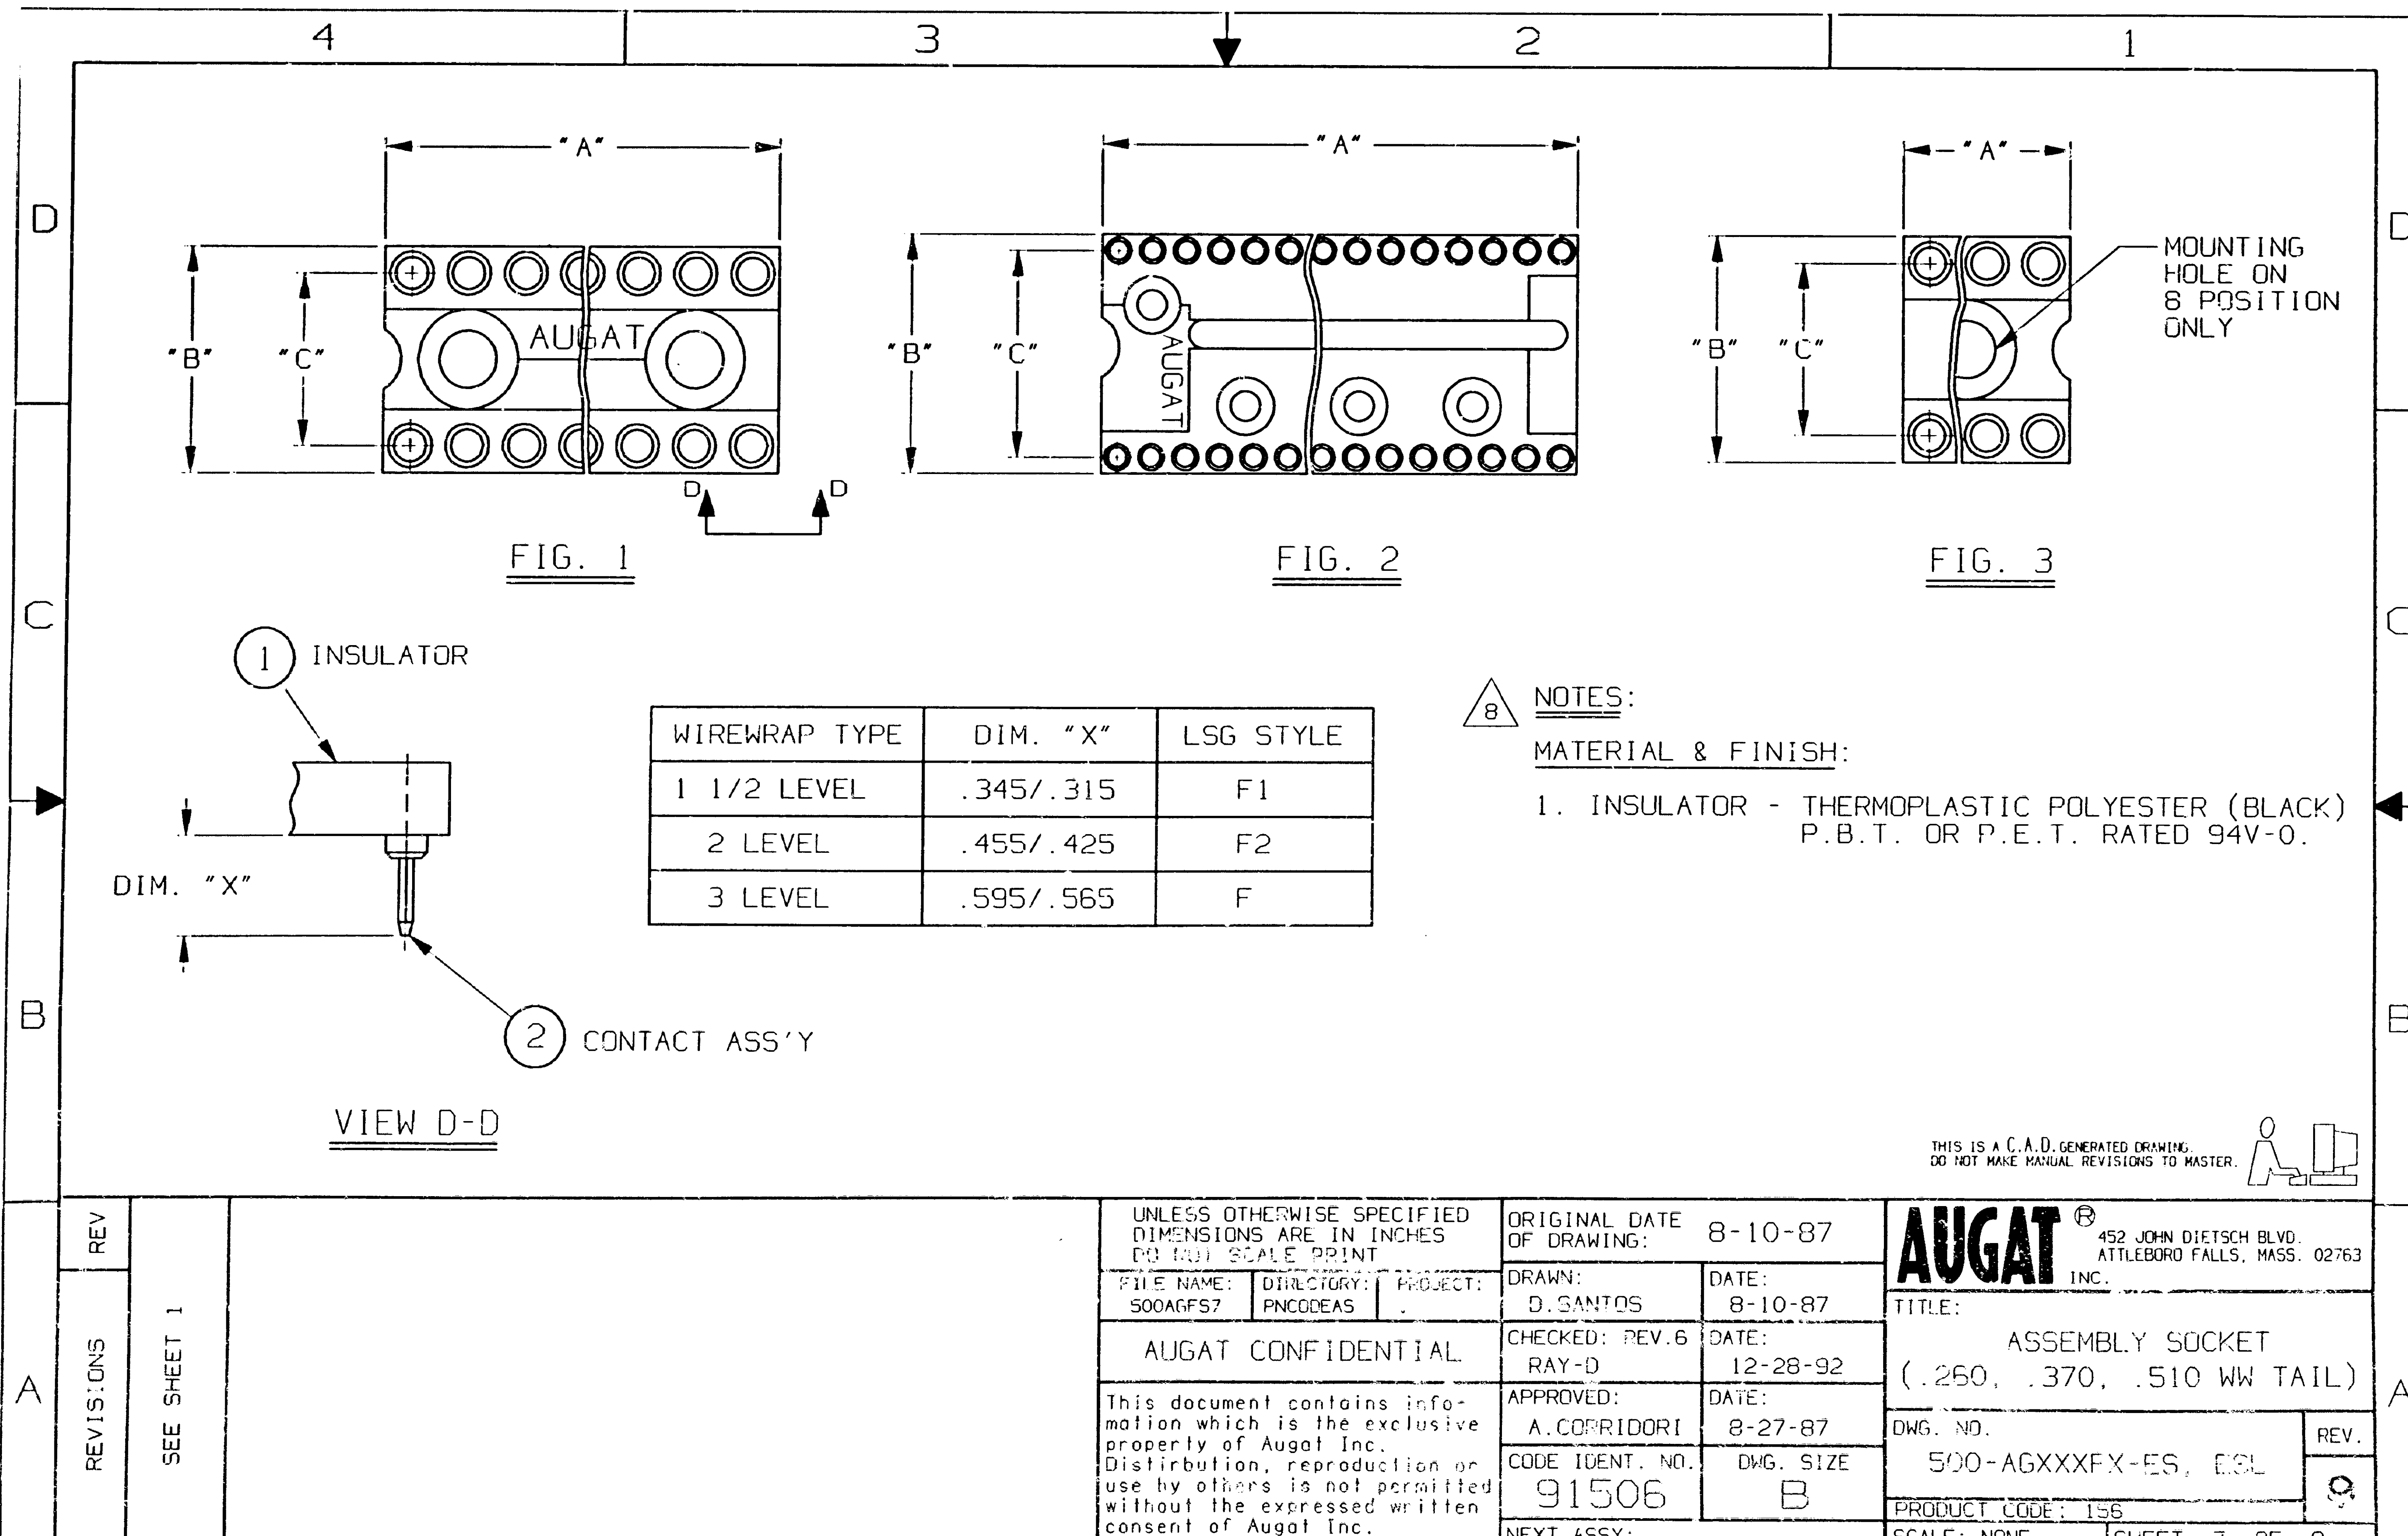

A	REV	
	REVISIONS	SEE SHEET 1

UNLESS OTHERWISE SPECIFIED DIMENSIONS ARE IN INCHES DO NOT SCALE PRINT			ORIGINAL DATE OF DRAWING: 8-10-87		<b>AUGAT</b> 452 JOHN DIETSCH BLVD. ATTLEBORO FALLS, MASS. 02763 INC.
FILE NAME: 500AGFS7	DIRECTORY: PNCODEAS	PROJECT:	DRAWN: D. SANTOS	DATE: 8-10-87	
AUGAT CONFIDENTIAL			CHECKED: REV. 6 RAY-D	DATE: 12-28-92	TITLE: ASSEMBLY SOCKET (.250, .370, .510 WW TAIL)
This document contains information which is the exclusive property of Augat Inc. Distribution, reproduction or use by others is not permitted without the expressed written consent of Augat Inc.			APPROVED: A. CORRIDORI	DATE: 8-27-87	DWG. NO. 500-AGXXXX-ES, E3L
			CODE IDENT. NO. 91506	DWG. SIZE B	REV.
NEXT ASSY:			PRODUCT CODE: 156		SCALE: NONE

单击下面可查看定价，库存，交付和生命周期等信息

[>>TE Connectivity\(泰科\)](#)