


DRAWING MADE IN AMERICAN PROJECTION

LOC 6 SHEET 14

© 1970 BY AMP INCORPORATED. ALL RIGHTS RESERVED. AMP PRODUCTS COVERED BY PATENTS AND/OR PATENTS PENDING.

REVISIONS			
LTR	DESCRIPTION	DATE	APPROVED
D	<del>REV PER G-571</del>	2/1/88	<i>[Signature]</i>
E	REV PER G-571	2/24/90	OKS/PSG
C	331366 OBSOLETE G-2340	DAP 4/10/87	<i>[Signature]</i>

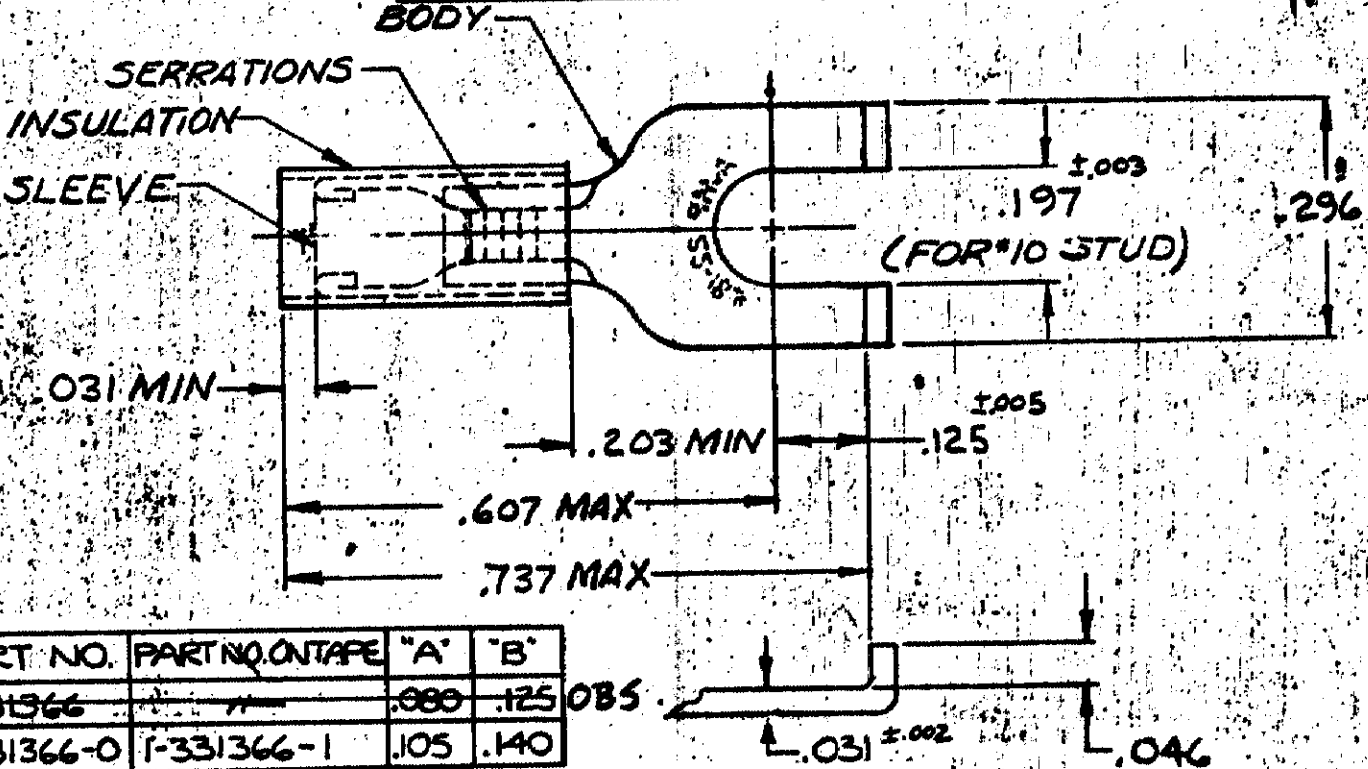

PART NO.	PART NO. ON TAPE	"A"	"B"
331366		.080	.125
1-331366-0	1-331366-1	.105	.140

FOR "A" TO "B" WIRE INS. DIA.  
 MARKING 22-18 FOR MILITARY  
 COMMERCIAL RANGE 22-16

1-331366-0 ON TAPE	1-331366-1	SLEEVE: COPPER (QQ-C-576)
WIRE	1-331366-0	BODY: COPPER (QQ-C-576)
Terminal	<del>331366</del> OBSOLETE	TIN PL (MIL-T-10727)
QTY	DESCRIPTION	INSULATION: NYLON
	PART NO	COLOR: RED
		MATERIAL & FINISH
UNLESS OTHERWISE SPECIFIED DIMENSIONS ARE IN INCHES. TOLERANCES ON: DECIMALS ±.008 ANGLES ±5°	CONTRACT NO.	AMP INCORPORATED HARRISBURG, PENNSYLVANIA
	DR. <i>[Signature]</i> 9-14-70	
MATERIAL	CHK. <i>[Signature]</i> 8-17-70	NAME WIRE TERMINAL
SEE TABLE	APPD. <i>[Signature]</i> 8-17-70	P.I.D.G. - FLANGED SPADE
	REL. <i>[Signature]</i> 8-17-70	WIRE SIZE: 22-16
	DSGN APPD	SIZE A CODE IDENT NO. 00779 NUMBER 331366
	OTHER APPD	SCALE NTS SHEET 1 OF 1

单击下面可查看定价，库存，交付和生命周期等信息

[>>TE Connectivity\(泰科\)](#)