
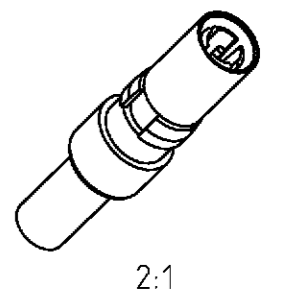



THIS DRAWING IS UNPUBLISHED. RELEASED FOR PUBLICATION 2000  
 © COPYRIGHT 2000 BY TYCO ELECTRONICS CORPORATION. ALL RIGHTS RESERVED.

LOC	DIST	REVISIONS				
P	LTR	DESCRIPTION	DATE	DWN	APVD	
GW	-	A1	SR10-0146-01	09APR2001	CM	KM
		A2	REV PER ECO-09-026495	01NOV09	KK	AEG

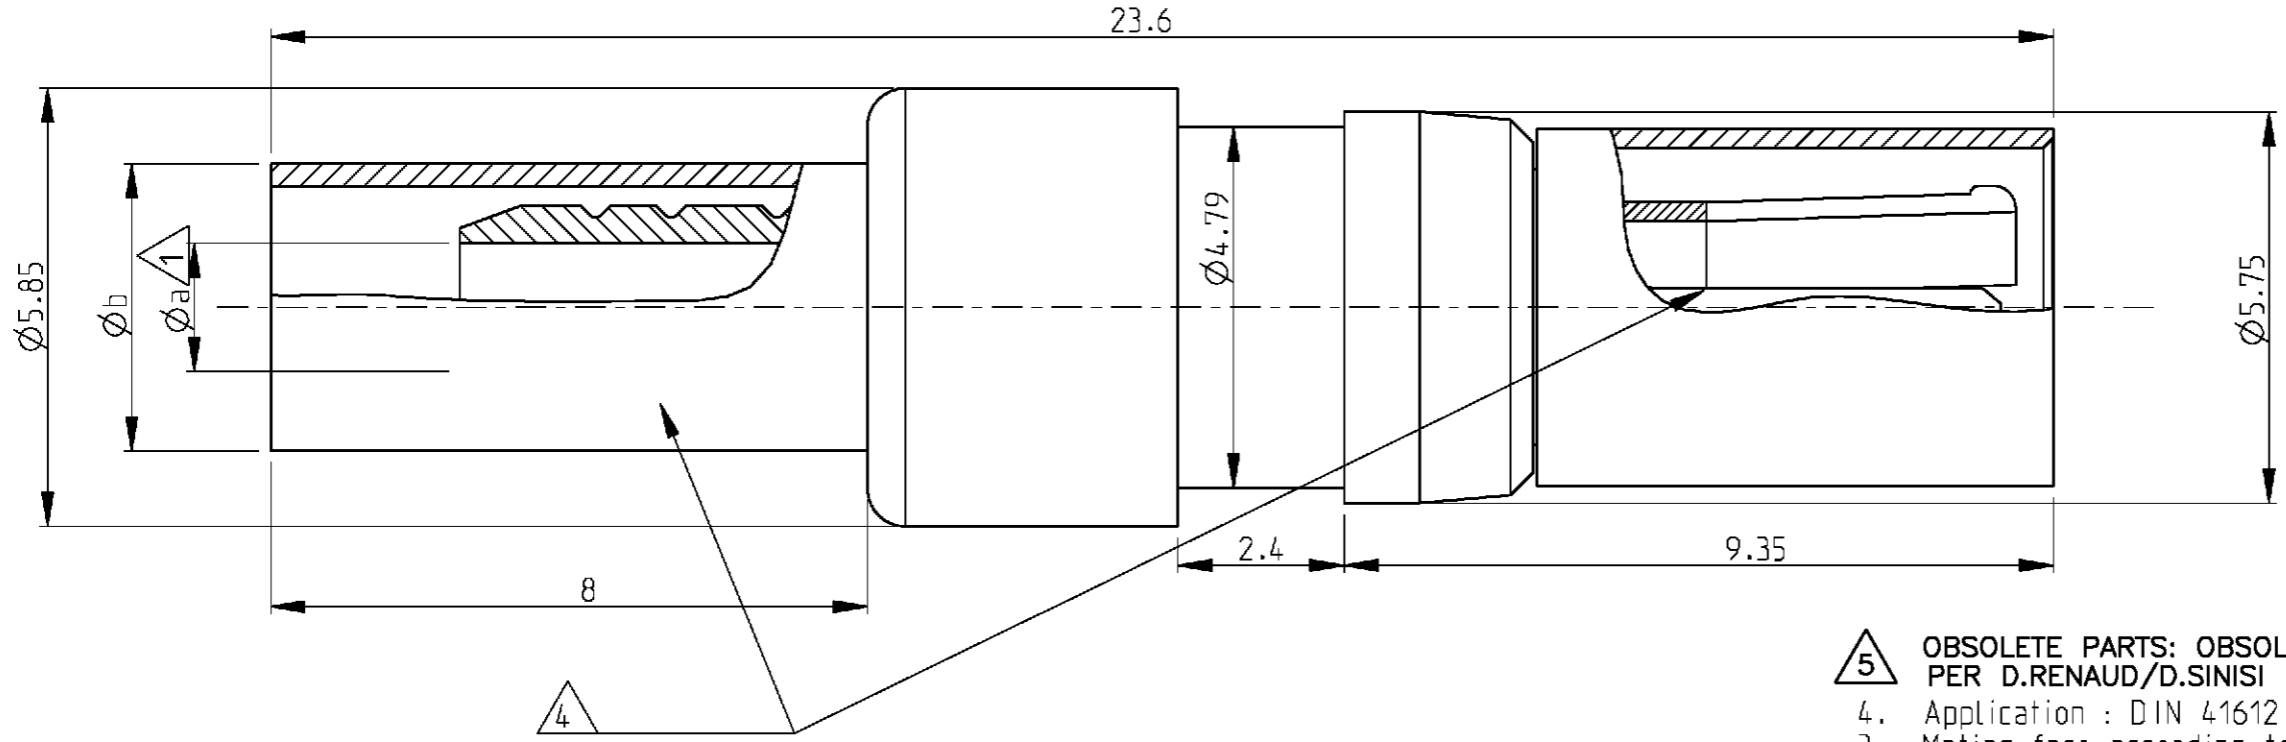

- 5 OBSOLETE PARTS: OBSOLETE CIS STREAMLINING PER D.RENAUD/D.SINISI
  - 4. Application : DIN 41612 Type M
  - 3. Mating face according to DIN 41626 Part 2
  - 2. Supplied as loose part
  - 1 Minimum dimension
- All dimensions are max dimensions unless otherwise specified

Old Nr	Tyco Nr	Cable Type	Dim a	Dim b	Description	Material	Plating
<del>5</del> OBSOLETE V23615-B302-E57A	<del>3-1393668-1</del>	RG179 B/U	1.7	3.85	Dielectric	PTFE	
					Outer Con.	Cu Be	1µm Au min in contact area
					Center Con.	Brass	1µm Au min in contact area
V23615-B302-E57	3-1393668-0	RG179 B/U	1.7	3.85	Dielectric	PTFE	
					Outer Con.	Cu Be	1µm Au min in contact area
					Center Con.	Brass	1µm Au min in contact area

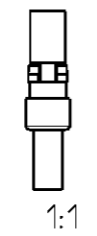

THIS DRAWING IS A CONTROLLED DOCUMENT FOR TYCO ELECTRONICS CORPORATION IT IS SUBJECT TO CHANGE AND THE CONTROLLING ENGINEERING ORGANIZATION SHOULD BE CONTACTED FOR THE LATEST REVISION.		DWN MOROBE 03APR2001 CHK MATTHEEUS 9APR2001 APVD BOZZER 9APR2001	<b>tyco</b> <b>Electronics</b> Tyco Electronics Oostkamp - Belgium
DIMENSIONS: mm	TOLERANCES UNLESS OTHERWISE SPECIFIED: 0 PLC ±0.5 1 PLC ±0.13 2 PLC ±0.013 3 PLC ±0.0001 4 PLC ANGLES ±	PRODUCT SPEC 108-71032 APPLICATION SPEC 114-71015 WEIGHT -	NAME <b>CABLE PLUG</b> <b>1.0/2.3 INSERT 75 Ohm</b>
MATERIAL -	FINISH -	SIZE A3	CAGE CODE 00779 DRAWING NO C-3-1393668-0 RESTRICTED TO -
		SCALE 10/1	SHEET 1 OF 1 REV A2

单击下面可查看定价，库存，交付和生命周期等信息

[>>TE Connectivity\(泰科\)](#)