


DRAWING MADE IN THIRD ANGLE PROJECTION

© COPYRIGHT 1977 BY AMP INCORPORATED, HARRISBURG, PA.
 ALL INTERNATIONAL RIGHTS RESERVED. AMP INCORPORATED PRODUCTS
 COVERED BY U. S. AND FOREIGN PATENTS AND/OR PATENTS PENDING.

3 207438-2 1. AS SHOWN.
 207438-3 1. SAME AS -2 EXCEPT:
 207438-5 2. LOOSE PIECE

~~DISCREPANCY EXCEPT:~~
 DISCREPANCY

REVISIONS		DATE	APPROVED
P. 5	ZONE		
G	OBSOLETED - 57EEN R-2613	12-87	RG AT
H	REV PER EC 0020 - 289-93	5-3-73	RK

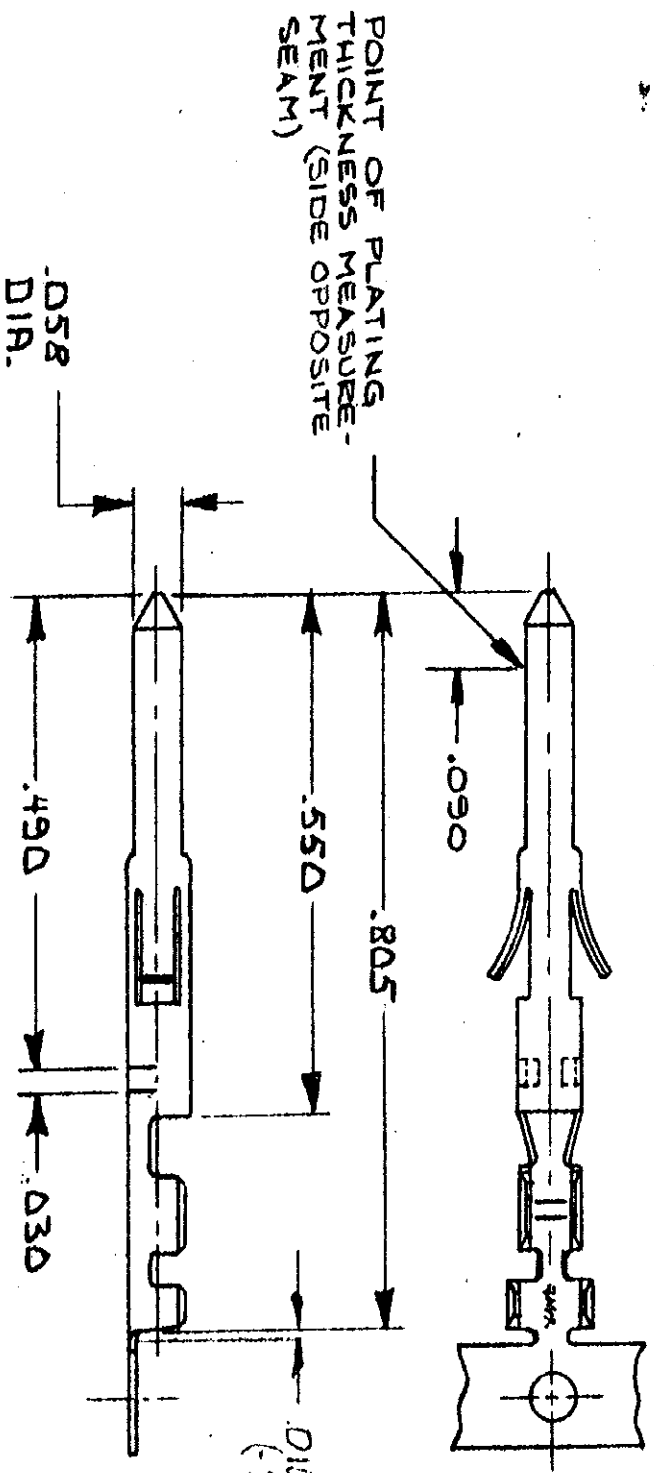

3 -8 1. SAME AS -8 EXCEPT;
 2. GOLD FLASH / III. PLATED.
 -9 1. SAME AS -8 EXCEPT;
 2. LOOSE PIECE.
 DID MAX CUTOFF (-3-5, -7 & -9 ONLY)

~~OBsolete EXCEPT:~~
 SELECT GOLD/III PLATED.
~~OBsolete EXCEPT:~~
 2. LOOSE PIECE.

1. WIRE RANGE = 22-28.
2. INSULATION RANGE = .036 - .054 D/A.
3. REVERSE REELED FOR MINI-APPLICATOR.

UNLESS OTHERWISE SPECIFIED DIMENSIONS ARE IN INCHES. TOLERANCES ON: DECIMALS ± .005 ANGLES ± .1°

MATERIAL BRASS		FINISH TIN PLATE	
CONTRACT NO. 3-2-77		NAME CONTACT, PIN	
APPROVED BY [Signature]		DRAWING NO. 207438	
DESIGN APPRO. [Signature]		CODE IDENT. NO. 00729	
OTHER APPRO.		SCALE 1/251	



CUSTOMER DRAWING

AMP 1470-15 (7-73)

单击下面可查看定价，库存，交付和生命周期等信息

[>>TE Connectivity\(泰科\)](#)